



This property appears to be IN the 100 year flood plain, & in insurance rate map zone AE, as per map 4854690022E Dated: 12-06-02 B.F.E. = 12.0'

This determination to be used for flood insurance rate purposes ONLY and is NOT to be relied upon for ANY other purpose. Surveyor makes no representation as to whether property may Flood.

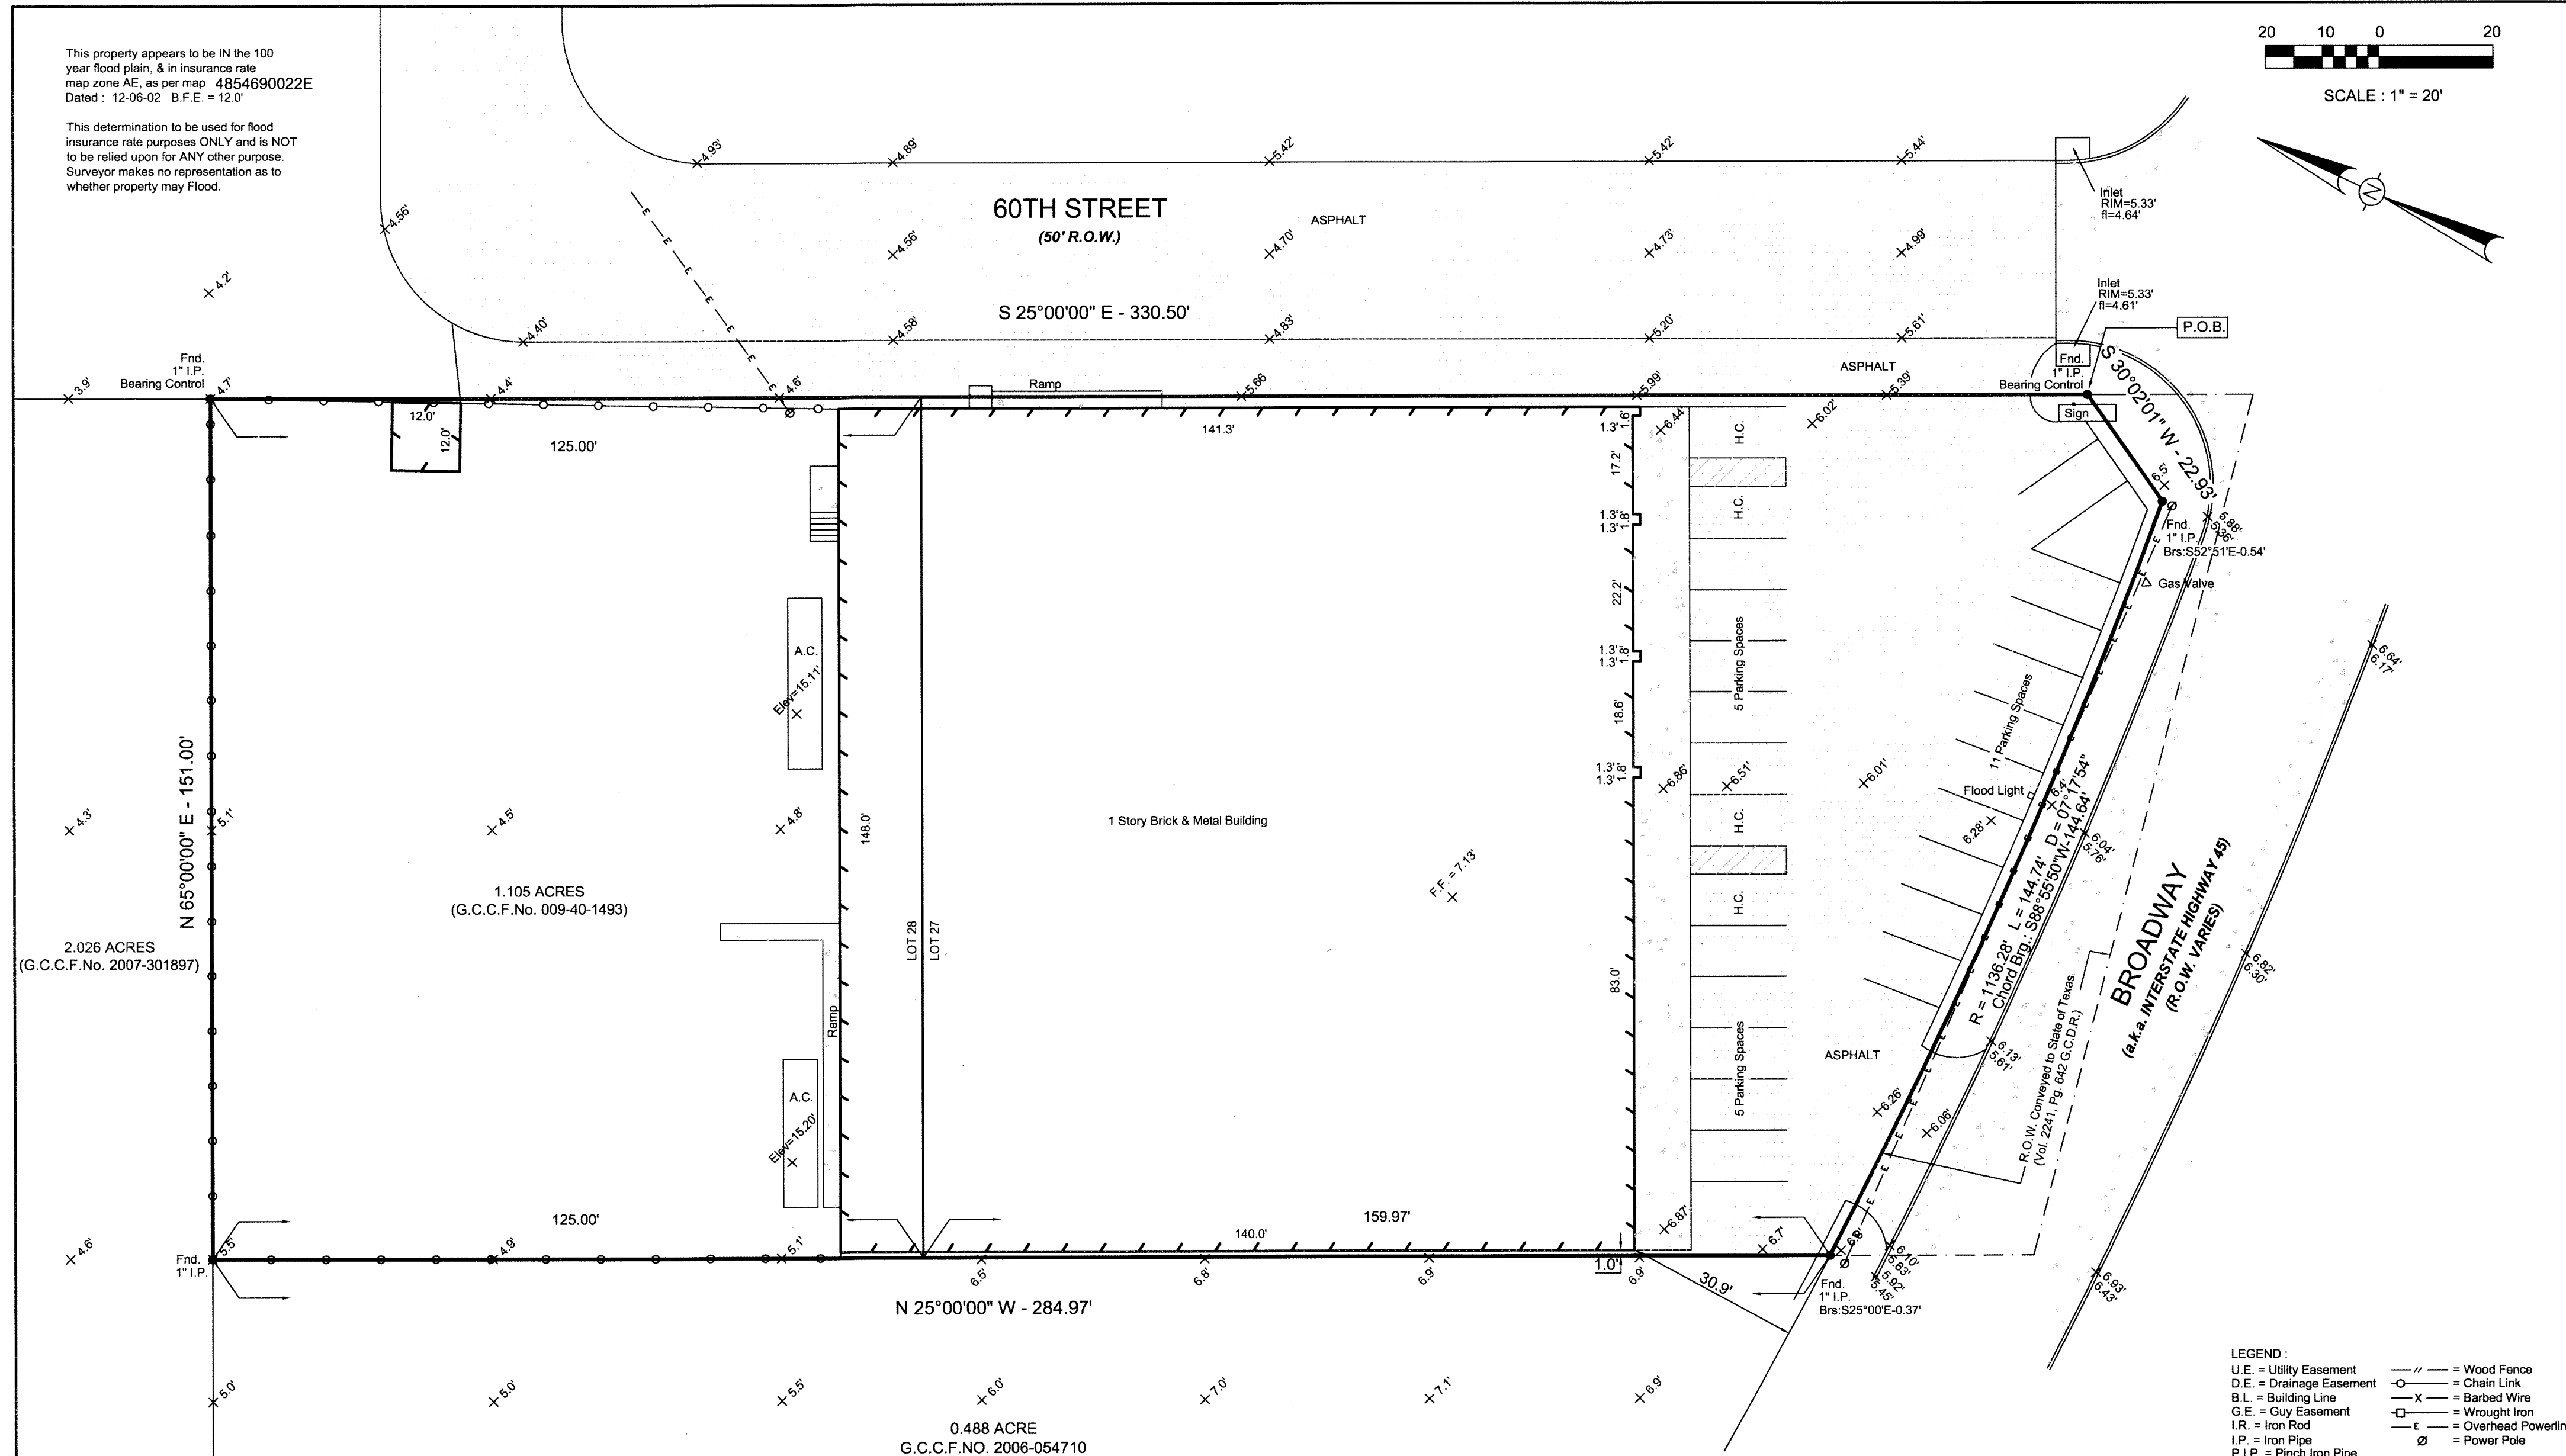

SCALE: 1" = 20'

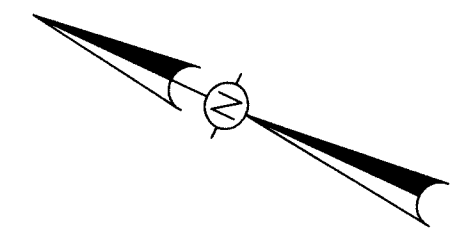


2.026 ACRES
(G.C.C.F.No. 2007-301897)

1.105 ACRES
(G.C.C.F.No. 009-40-1493)

0.488 ACRE
G.C.C.F.NO. 2008-054710

BENCHMARK: AW0455/H1237;
ELEV. = 9.81', 1988 ADJUSTMENT

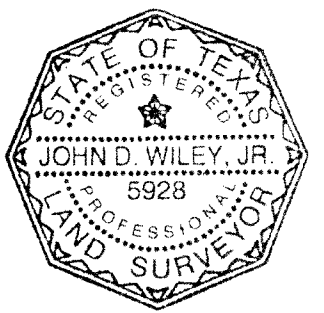

- LEGEND:
- U.E. = Utility Easement
 - D.E. = Drainage Easement
 - B.L. = Building Line
 - G.E. = Guy Easement
 - I.R. = Iron Rod
 - I.P. = Iron Pipe
 - P.I.P. = Pinch Iron Pipe
 - P.P. = Power Pole
 - Stm.S.E. = Storm Sewer Easement
 - San.S.E. = Sanitary Sewer Easement
 - G.C.C.F.No. = Galveston County Clerk File Number
 - = Wood Fence
 - = Chain Link
 - X — = Barbed Wire
 - □ — = Wrought Iron
 - ε — = Overhead Powerline
 - ⊙ = Power Pole

I hereby certify that this survey under my supervision was this day made on the ground and that this plat correctly represents the property legally described hereon (or on attached sheet). That the facts found at the time of this survey show the improvements and that there are no visible encroachments apparent on the ground, except as shown, to the best of my knowledge, surveyed 05-05-09.

John D. Wiley, Jr. 05-15-09
JOHN D. WILEY, JR., R.P.L.S. No. 5928 Date

This survey is certified for this transaction only, is not transferable to additional institutions or subsequent owners. If this survey does not bear an original BLUE seal it is invalid and should not be relied upon for any purpose.

Note:
This survey was performed without benefit of a title commitment and may not show all deed restrictions, easements, building lines and other matters of record.

- Notes:
- Basis for Bearings: RECORD PLAT
 - Distances shown are ground distances.
 - All abstracting done by title company.
 - All B.L.'s & U.E.'s taken from recorded plat unless otherwise noted.
 - Dimension ties from improvements to property lines are calculated and should NOT be relied upon for construction and/or removal of any improvements including fences.
 - Building dimensions may not be used to calculate square footage.
 - This property subject to any and all recorded and unrecorded easements. Surveyor has made no investigation or independent search for easements of record, encumbrances, restrictive covenants or ownership title evidence.

* BEING MORE PARTICULARLY DESCRIBED BY METES AND BOUNDS ATTACHED.

LOT: *	BLOCK: *	SUBDIVISION: TRIMBLE AND LINDSEY SURVEY	SECTION: -
RECORDATION: G.C.C.F.NO. 009-40-1493	COUNTY: GALVESTON	STATE: TEXAS	
ADDRESS: 6000 BROADWAY	CITY: GALVESTON	LENDER: -	
PURCHASER: -	TITLE COMPANY: -	G.F. # -	

DaRam Engineers, Inc.
5455 Dashwood, Suite 700
Bellaire, Texas 77401
(713) 528-1552 * FAX (713) 529-8997

SURVEYED BY: W.W.
DRAWN BY: NS
DRAWING NO.: Broadway 6000